


**Massachusetts Department of Environmental Protection**  
 Bureau of Resource Protection - Wetlands  
**WPA Form 8A – Request for Certificate of Compliance**  
 Massachusetts Wetlands Protection Act M.G.L. c. 131, §40

DEP File Number:

Provided by DEP

**A. Project Information**

**Important:**  
 When filling out forms on the computer, use only the tab key to move your cursor - do not use the return key.

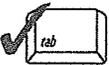

Upon completion of the work authorized in an Order of Conditions, the property owner must request a Certificate of Compliance from the issuing authority stating that the work or portion of the work has been satisfactorily completed.

1. This request is being made by:

Robert H. Kierce  
 Name  
55 GAGNON Rd  
 Mailing Address  
Lowell MA 01854  
 City/Town State Zip Code  
978 505 5576  
 Phone Number

2. This request is in reference to work regulated by a final Order of Conditions issued to:

Robert H. Kierce  
 Applicant  
10/11/22 206-0817  
 Dated DEP File Number

3. The project site is located at:

55 GAGNON Rd Lowell  
 Street Address City/Town  
0052 2515 0055 55  
 Assessors Map/Plat Number Parcel/Lot Number

4. The final Order of Conditions was recorded at the Registry of Deeds for:

Robert & Janice Kierce  
 Property Owner (if different)  
Middlesex 37438 138  
 County Book Page

Certificate (if registered land)

5. This request is for certification that (check one):

- the work regulated by the above-referenced Order of Conditions has been satisfactorily completed.  
 the following portions of the work regulated by the above-referenced Order of Conditions have been satisfactorily completed (use additional paper if necessary).

---




---



---

- the above-referenced Order of Conditions has lapsed and is therefore no longer valid, and the work regulated by it was never started.

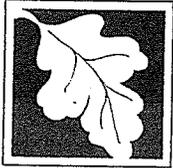

**Massachusetts Department of Environmental Protection**  
Bureau of Resource Protection - Wetlands  
**WPA Form 8A – Request for Certificate of Compliance**  
Massachusetts Wetlands Protection Act M.G.L. c. 131, §40

DEP File Number:

Provided by DEP

---

### A. Project Information (cont.)

6. Did the Order of Conditions for this project, or the portion of the project subject to this request, contain an approval of any plans stamped by a registered professional engineer, architect, landscape architect, or land surveyor?

Yes


If yes, attach a written statement by such a professional certifying substantial compliance with the plans and describing what deviation, if any, exists from the plans approved in the Order.

No

---

### B. Submittal Requirements

Requests for Certificates of Compliance should be directed to the issuing authority that issued the final Order of Conditions (OOC). If the project received an OOC from the Conservation Commission, submit this request to that Commission. If the project was issued a Superseding Order of Conditions or was the subject of an Adjudicatory Hearing Final Decision, submit this request to the appropriate DEP Regional Office (see <http://www.mass.gov/eea/agencies/massdep/about/contacts/find-the-massdep-regional-office-for-your-city-or-town.html>).

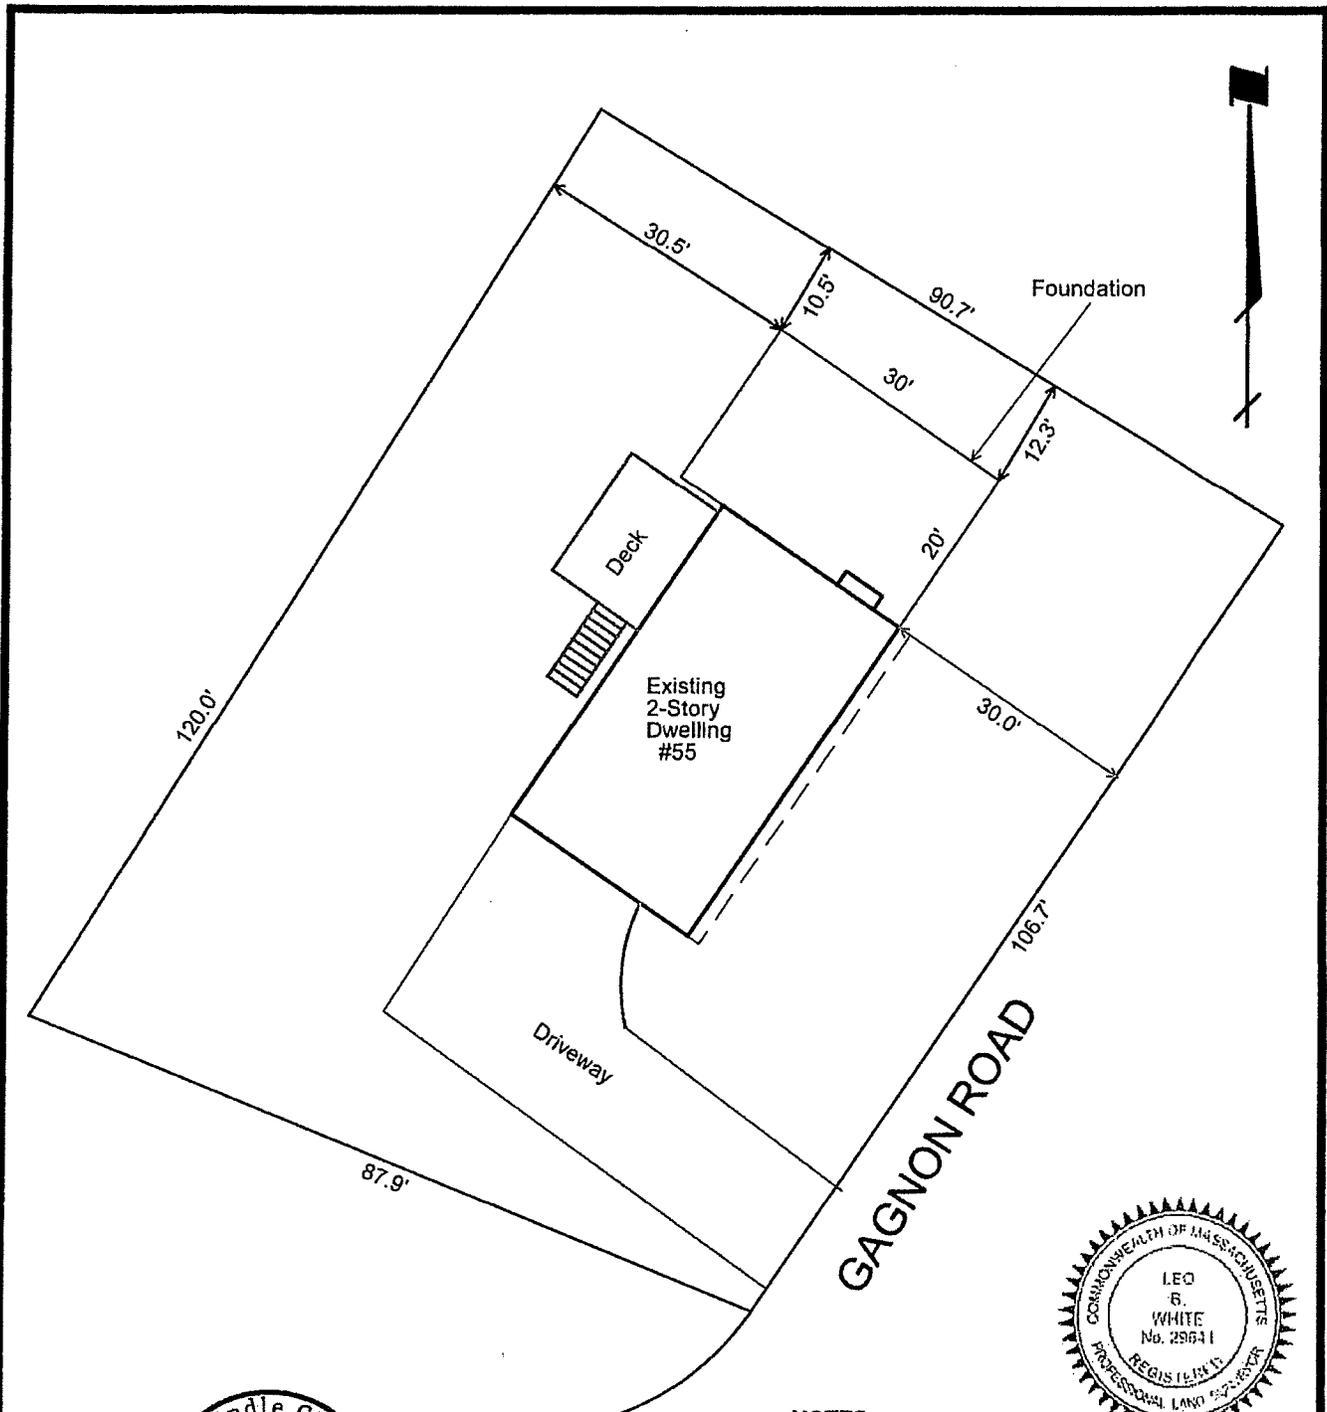

Spindle City Surveying & Consulting LLC  
 Lowell, MA  
 978-364-0138



*Leo B. White*  
 Leo B. White, PLS

**NOTES**

- 1) Middlesex North Deed Book 36680, Page 180
- 2) Middlesex North Plan Book 126, Plan 125
- 3) Plan should not be utilized for determining property boundaries

<b>AS BUILT PLAN</b>		
55 Gagnon Rd., Lowell, MA 01854		
Parcel 2515-55		
DATE: 11/28/2022	SCALE: 1" = 20'	DRAWN BY: BW

